

additional Ceonothus species planted here to fill gap'

Plants for Car Park
 Bergenia cordifolia 'Silberlicht'
 Cytisus x hybridus
 Hebe 'Autumn Glory'
 Lavandula angustifolia 'Hidcote'
 Sarcococca humilis

Choysa ternata 'Sundance'

Chaenomeles x superba 'Crimson and Gold'

Pieris 'Forest Flame'

Sedum spectabile

Malus 'Falslaff'

Geranium renardii

Helleborus niger

Lavandula angustifolia 'Hidcote'

Manchester Road

Lavandula angustifolia 'Hidcote'

Geranium renardii

Helleborus niger

Malus 'James Grieve'

Pieris 'Forest Flame'

Sedum spectabile

Chaenomeles x superba 'Crimson and Gold'

Choysa ternata 'Sundance'

Stachys byzantia

Bergenia 'Silberlicht'

Verbena bonariensis

1 no. Buddlejia davidii 'Nanho's Purple'

Pyracantha 'Orange Chamer' and Pyracantha 'Soleil d'Or' on rear wall

Stachys and Bergenia

Viburnum opulus 'Compactum'

Astrantia major

Viburnum x burkwoodii 'Anne Russell'

Geranium renardii

Acer palmatum 'Osakazuki'

Anemone huphensis 'September Charm'

Luzula nivea

Rosa 'Paul's Lemon Pillar'

Viburnum x burkwoodii 'Anne Russell'

Pinus mungo

Geranium renardii

Astrantia major

Viburnum davidii

KEARSLEY MOUNT METHODIST CHURCH

- Hydrangea macrophylla subsp. 'Serrata'
 - Pinus mungo
 - Stipa gigantea

- Acer palmatum 'Dissectum'

- Atropurpureum'

- Festuca glauca

Iris latifolia

Hedera 'Glacier'

Hedera 'Glacier'

Hedera sp.

Lavandula angustifolia


Lavandula angustifolia

- 1 no Hydrangea macrophylla subsp. 'Serrata'

- 1 no. Sarcococca hookeriana diglyna

Fruiting Hedgerow
 Corylus avellana
 Ribes nigrum 'Ben Lomond'
 Ribes Malting Admiral'
 Ribes rubrum 'Roland'
 Ribes rubrum 'White Pearl'
 Ribes var. reclinatorum 'Invicta'

Bed 2
 Planted with a mixture of:
 Allium cristophili
 Allium schoenoprasum
 Chamaemelum nobile
 Foeniculum vulgare
 Geranium wallichianum 'Buxtons'
 Lavandula angustifolia 'Hidcote'
 Melissa officinalis
 Mentha cervina
 Origanum vulgare
 Rosmarinus officinalis
 Salvia officinalis
 Thymus 'Doone Valley'
 Verbena bonariensis

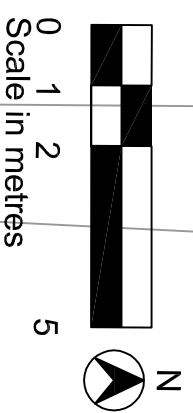

Notes		DATE		REVISION NOTES		ISSUE		CHKD	
1) Figured dimensions to be taken. Do not scale dimensions. Contractors must verify all dimensions on site before preparing shop drawings or commencing any work.		26.09.11		REV A - as built drawing					
2) Copyright © This drawing must not be reproduced without the permission of Profittis CIC									
3) Reproduced from 1988 Ordnance Survey mapping with permission of the controller of HMSO.									
DESIGN	PLANNING	TEMPER	CONTRACT						
KEY									
recycled plastic decking									
concrete flags (900x600mm)									
gravel and boulders									
concrete flags (450x450mm)									
raised beds									
date stone feature									
planting									
water feature									
metal seat									
tegula set edging									
water butts and downspouts									
raised concrete edging									
 Profittis Landscape Architects 403 Kingsley Business Centre Ramsley Hill Rossendale B54 8EG Tel: 01706 223700 email: communal@profittis.co.uk www.profittis.com		CLIENT Kearsley Mount Methodist Church PROJECT Church Gardens TITLE Layout Plan - AS BUILT SCALE 1:200 at A3 DATE May 2011 DRAWN BY RM CHECKED BY MP DRAWING NO 057/L01 rev a PROJECT CODE 057 ISSUE							